


OVERALL FLOORPLAN
3/32"=1'-0"



1882 CAMBRIDGE PLACE

DECEMBER 27, 2012

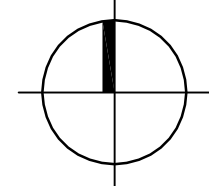