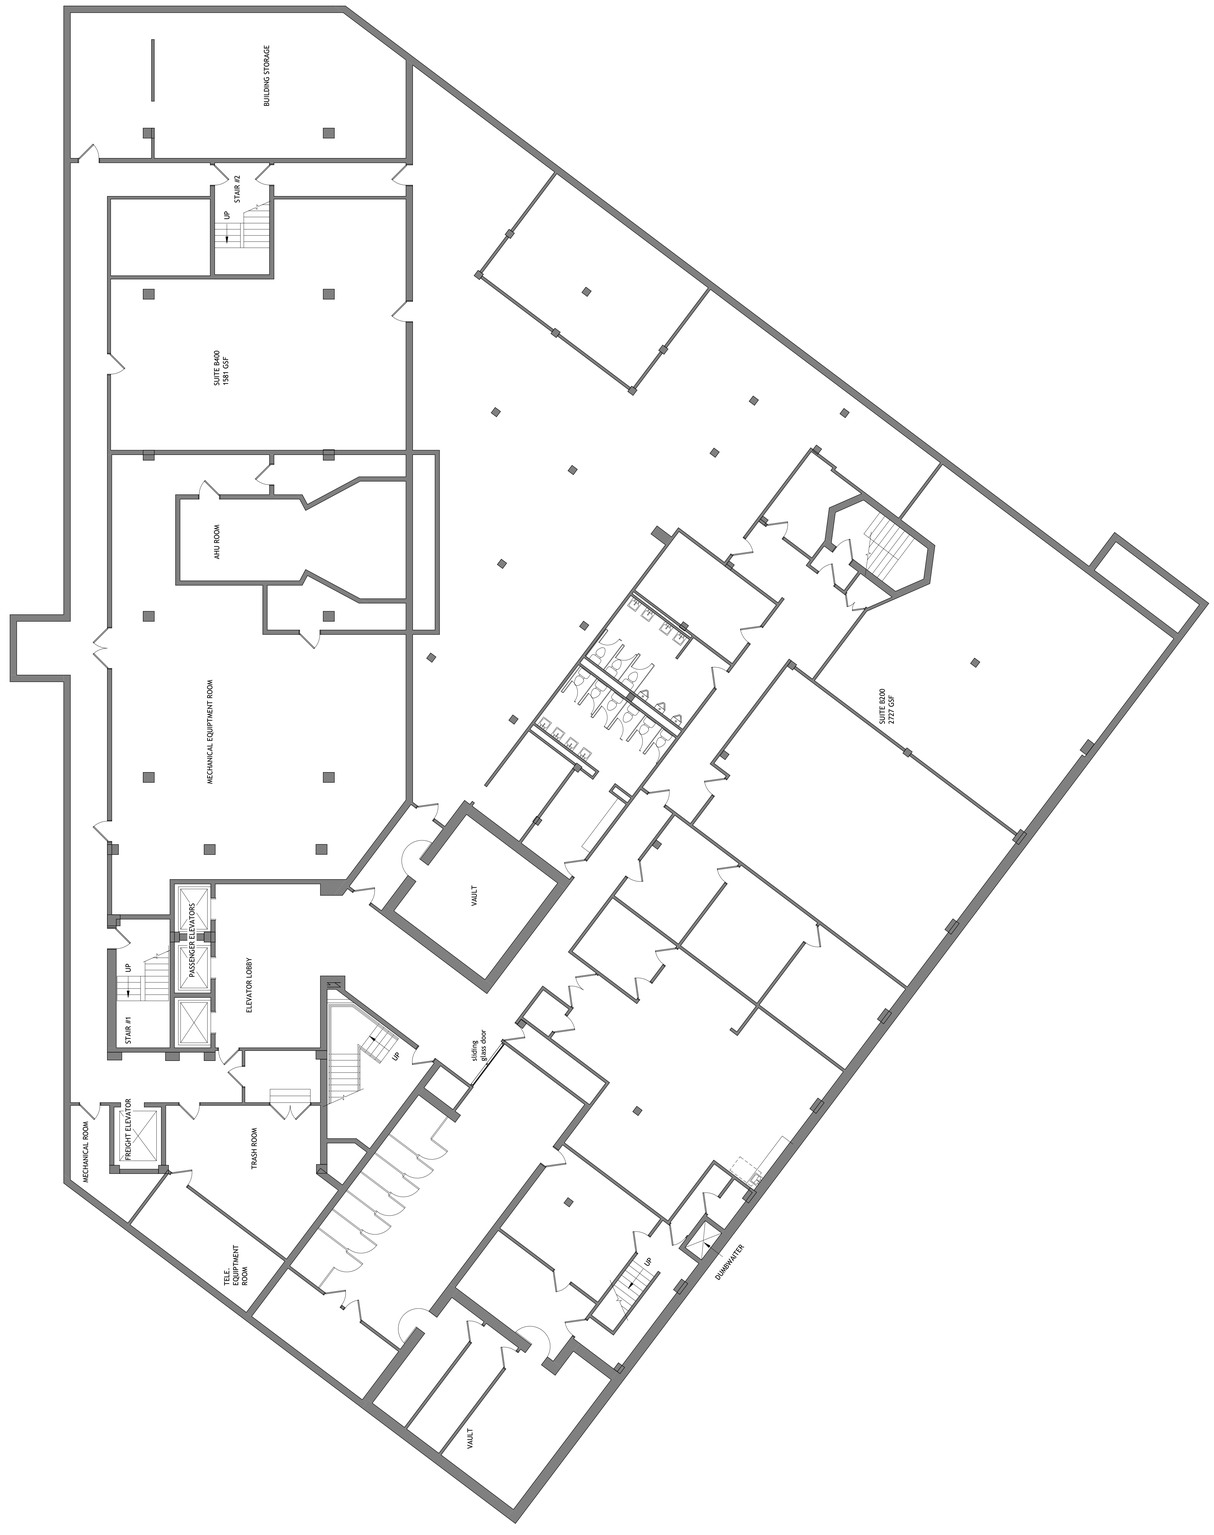

1 BASEMENT
1/8" = 1'-0"

Gallina DEVELOPMENT CORPORATION

1890 S WINTON RD
SUITE 100
ROCHESTER, NY 14618
p 585.654.6650

ONE EAST AVE

HISTORICAL RENOVATION PROJECT

BASEMENT

Date	04.24.26
Drawn by	EK
Checked by	Checker

A-1

Scale 1/8" = 1'-0"