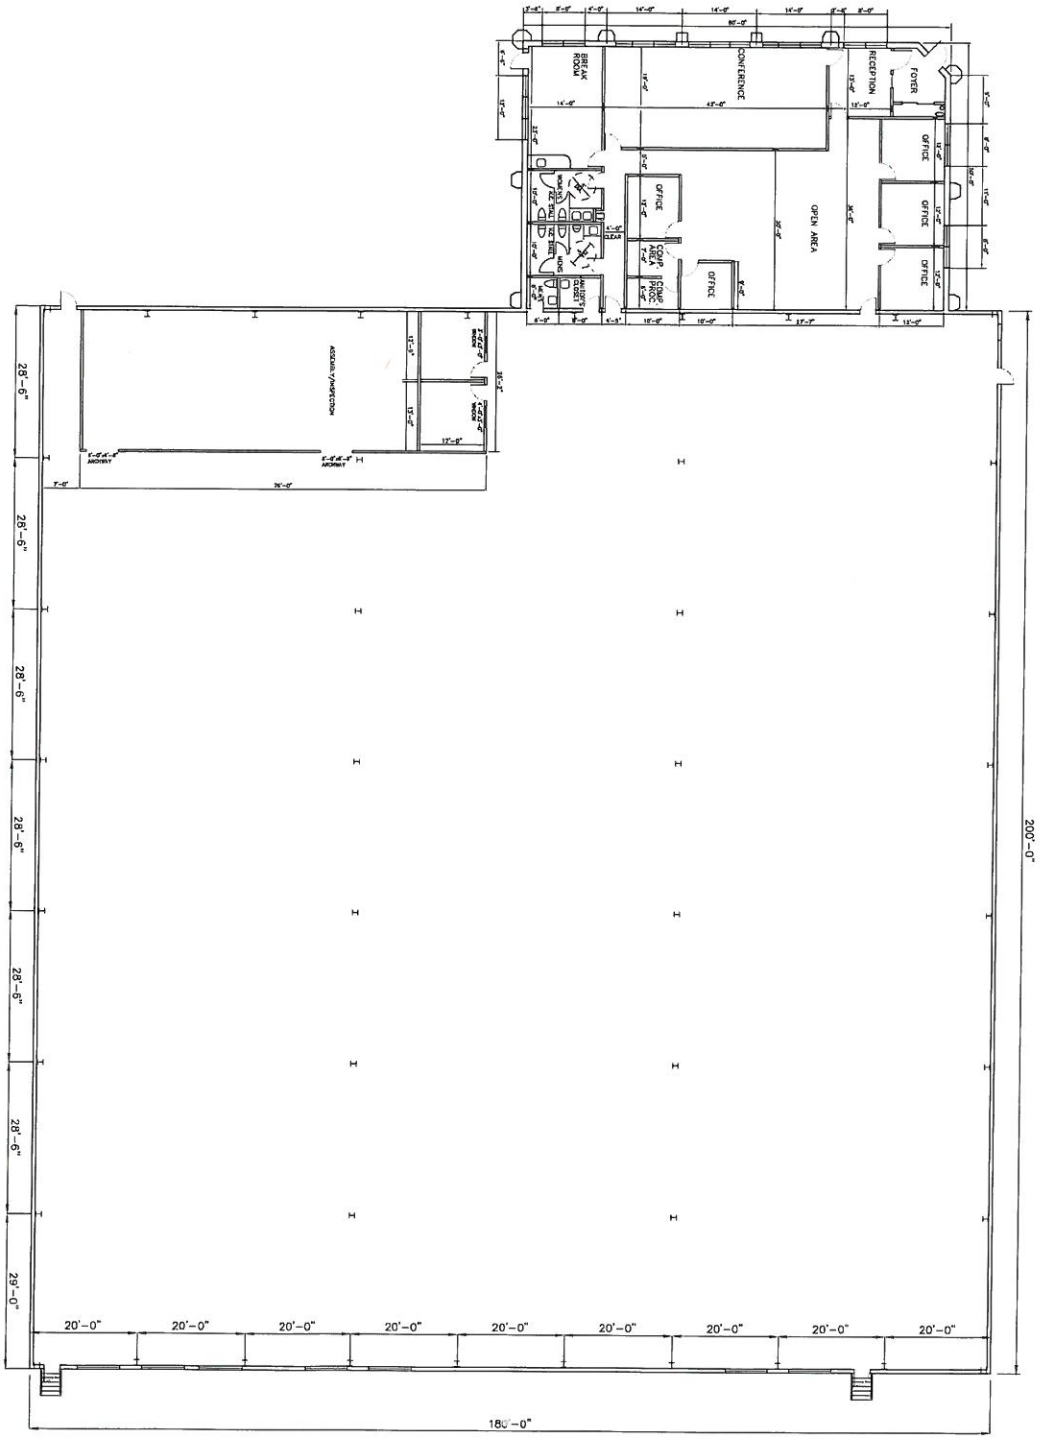

FLOOR PLAN
SCALE: 3/32"=1'-0"

45 vp drive

1 of 1

Client: GALLINA DEVELOPMENT CORPORATION
1873 SOUTH WINTON ROAD, SUITE 220, ROCHESTER, NEW YORK 14618

Project: LOT NO. 9 OF THE VANTAGE POINT BUSINESS CENTER
TOWN OF OGDEN, MONROE COUNTY, NEW YORK

Drawing: 45 VANTAGE POINT DRIVE, OGDEN, NEW YORK
AS-BUILT FLOOR PLAN

Scale	3/32"=1'-0"
Date	10/27/2010
Job No.	2010[illegible]3
Designed by	
Drawn by	RGH
Checked by	CEM
Approved by	

No. REVISIONS Date

DRAWING ALTERATION

CORNELES ENGINEERING, P.C.
3495 WINTON PLACE, BLDG E, SUITE 200
ROCHESTER, NEW YORK 14623
TEL. 585-427-0310 FAX 585-427-0316
www.CORNELESENGINEERING.com